


# 220 Lexington Green Circle

## Second Floor - Floor Plan

Suite 200, 202, & 210:  
8,102 contiguous SF

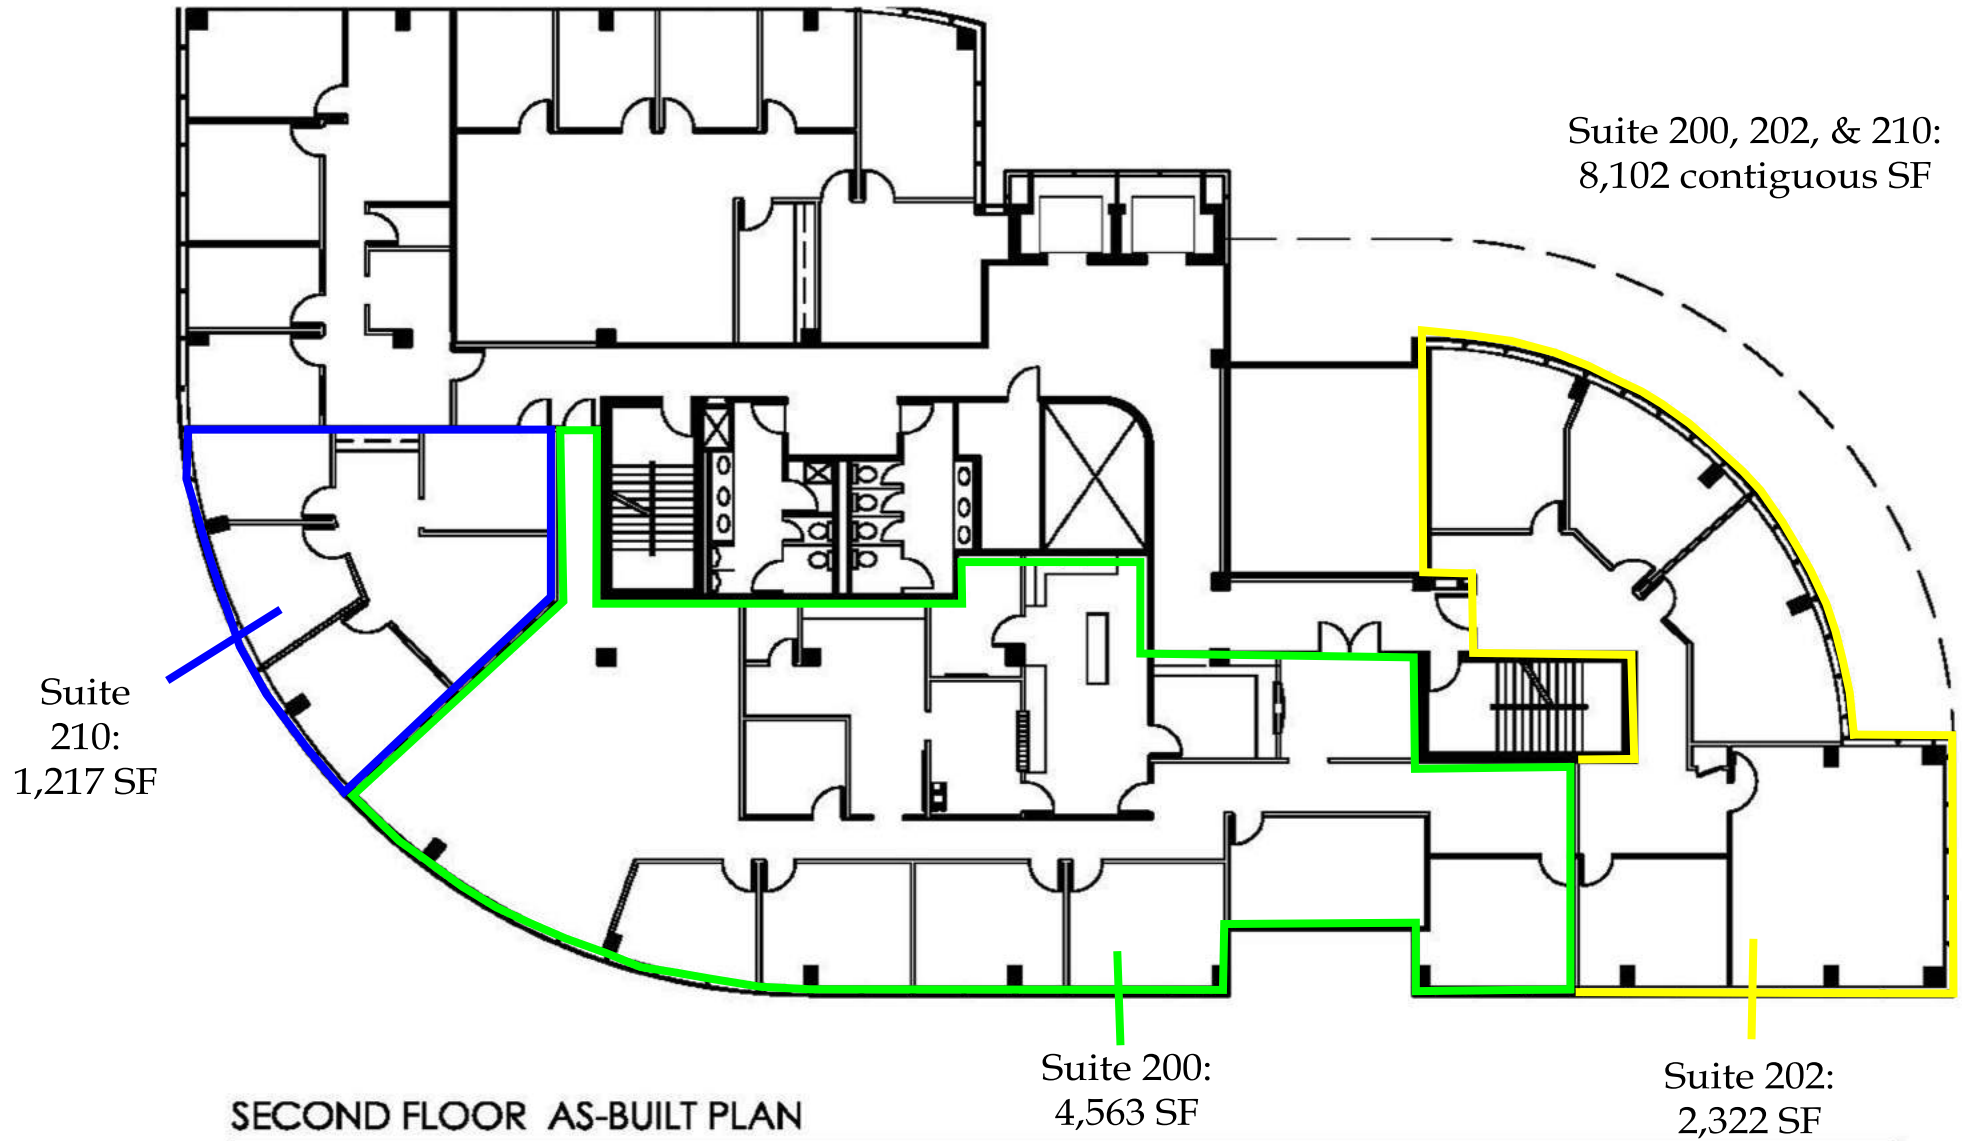


Contact:  
Clay Angelucci  
O: 859.309.0099 x223  
C: 859.338.8800  
Clay@BALrealstate.com

Peter Barr CCIM, SIOR  
O: 859.309.0099 x221  
C: 859.351.7924  
Peter@BALrealstate.com

# 220 Lexington Green Circle

## Fourth Floor - Floor Plan

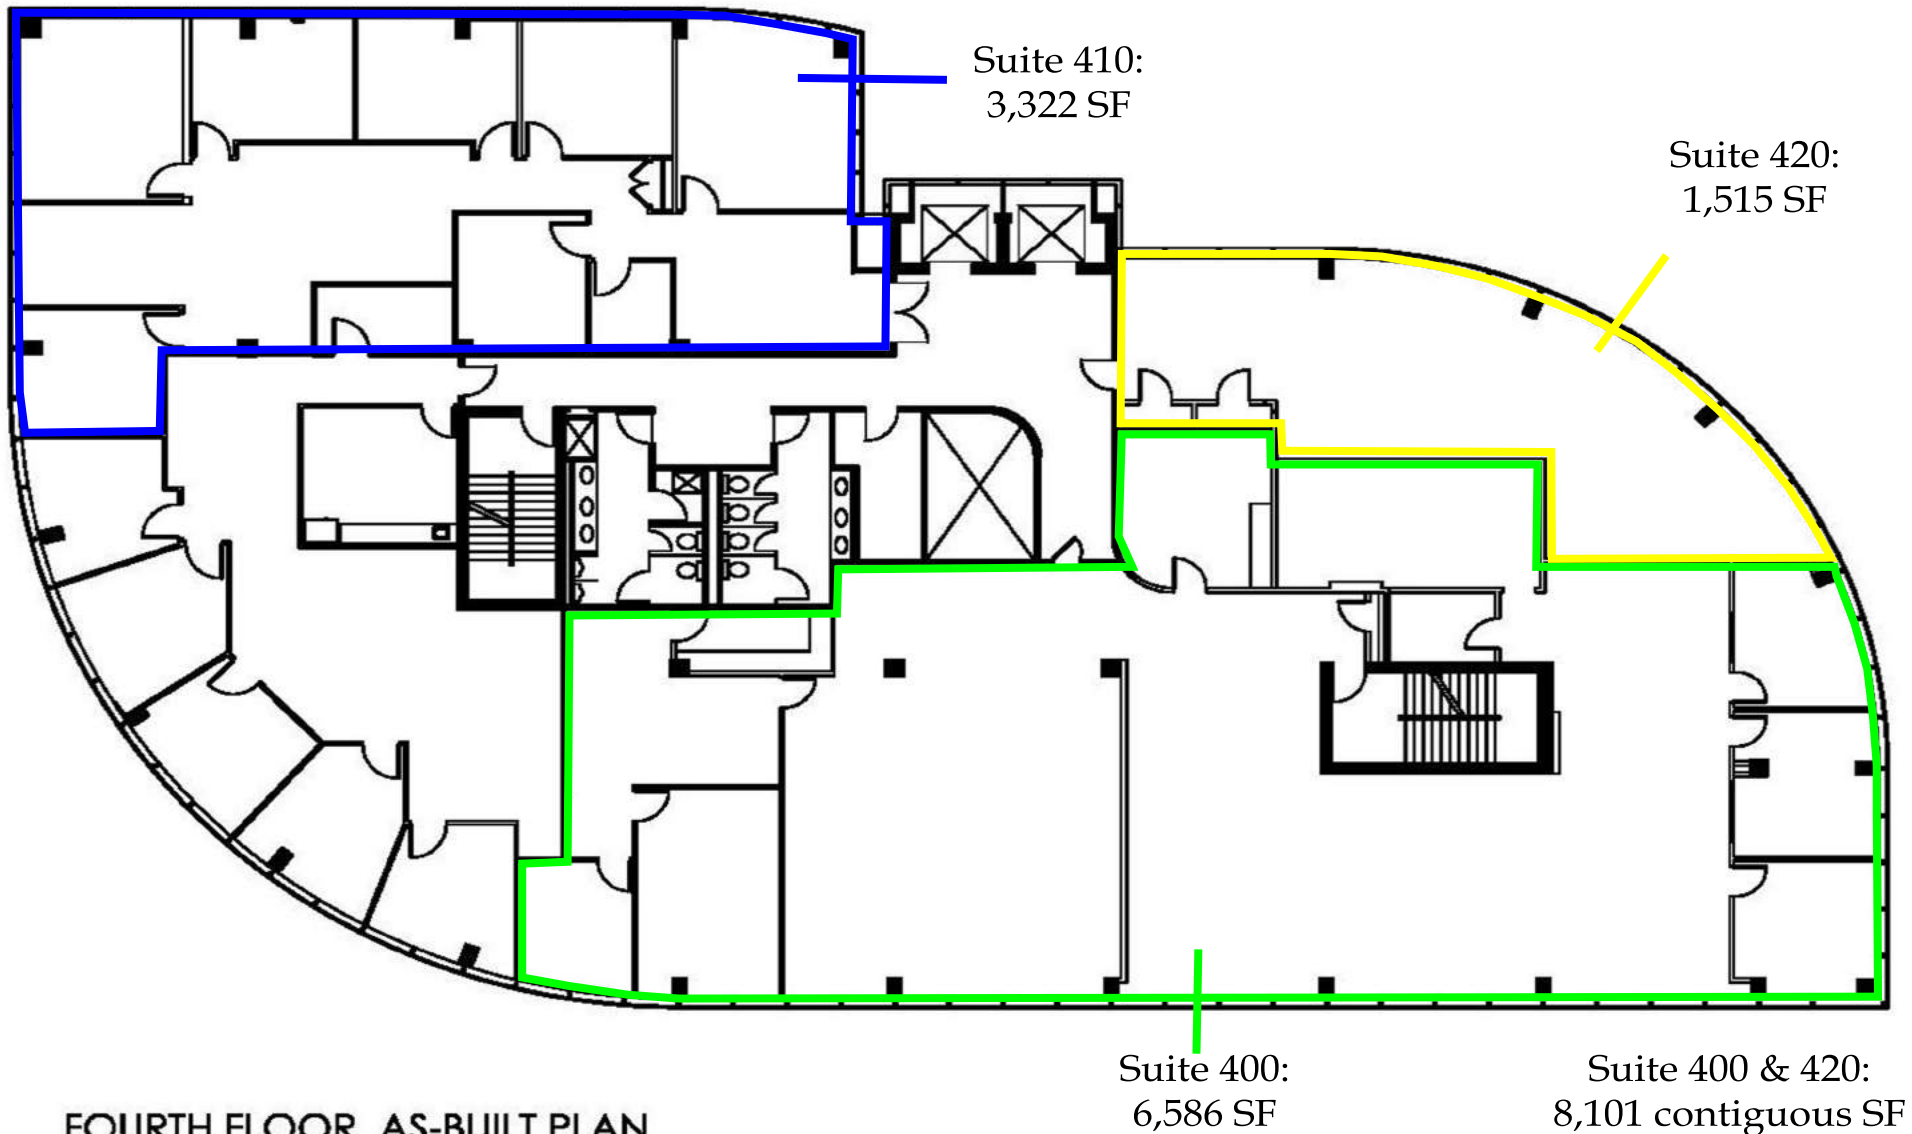

FOURTH FLOOR AS-BUILT PLAN


Contact:

Clay Angelucci  
O: 859.309.0099 x223  
C: 859.338.8800  
Clay@BALrealstate.com

Peter Barr CCIM, SIOR  
O: 859.309.0099 x221  
C: 859.351.7924  
Peter@BALrealstate.com

# 220 Lexington Green Circle

## Fifth Floor - Floor Plan

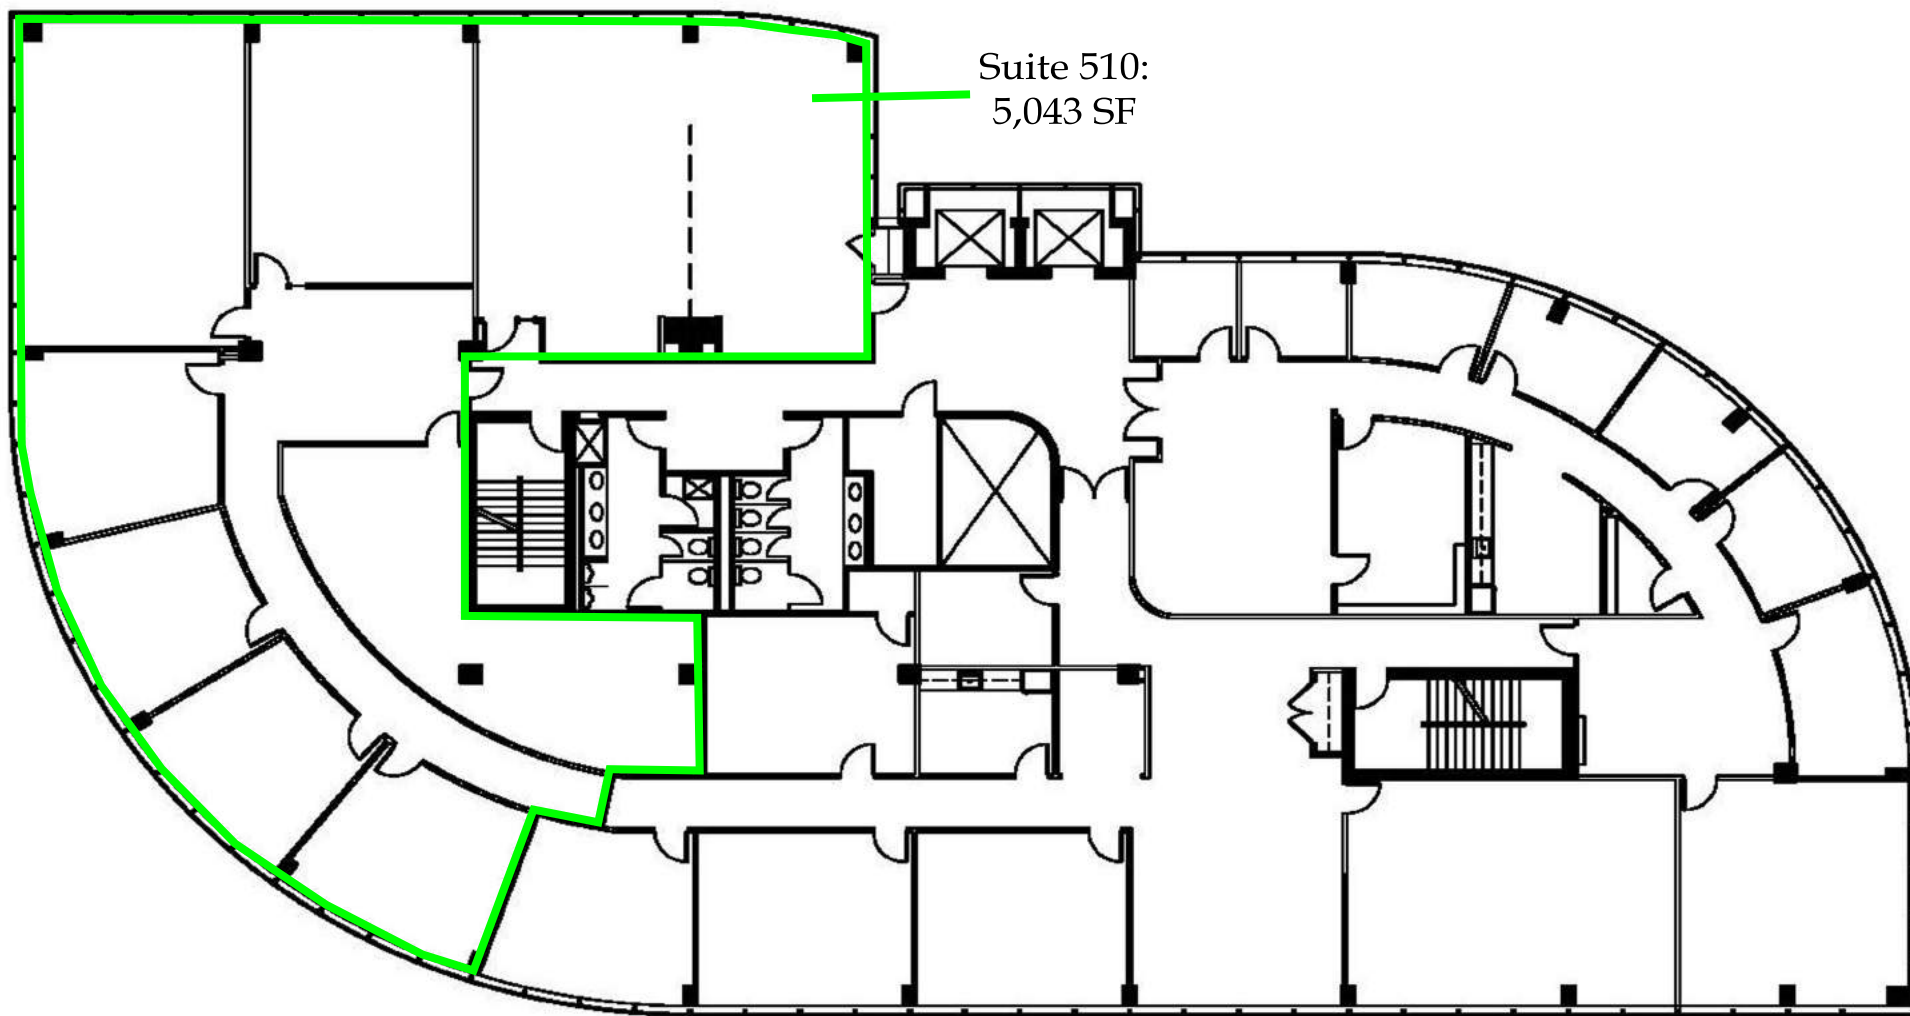

FIFTH FLOOR AS-BUILT PLAN

Contact:

Clay Angelucci

O: 859.309.0099 x223

C: 859.338.8800

Clay@BALrealstate.com

Peter Barr CCIM, SIOR

O: 859.309.0099 x221

C: 859.351.7924


Peter@BALrealstate.com



BLOCK+LOT

# 220 Lexington Green Circle

## Sixth Floor - Floor Plan

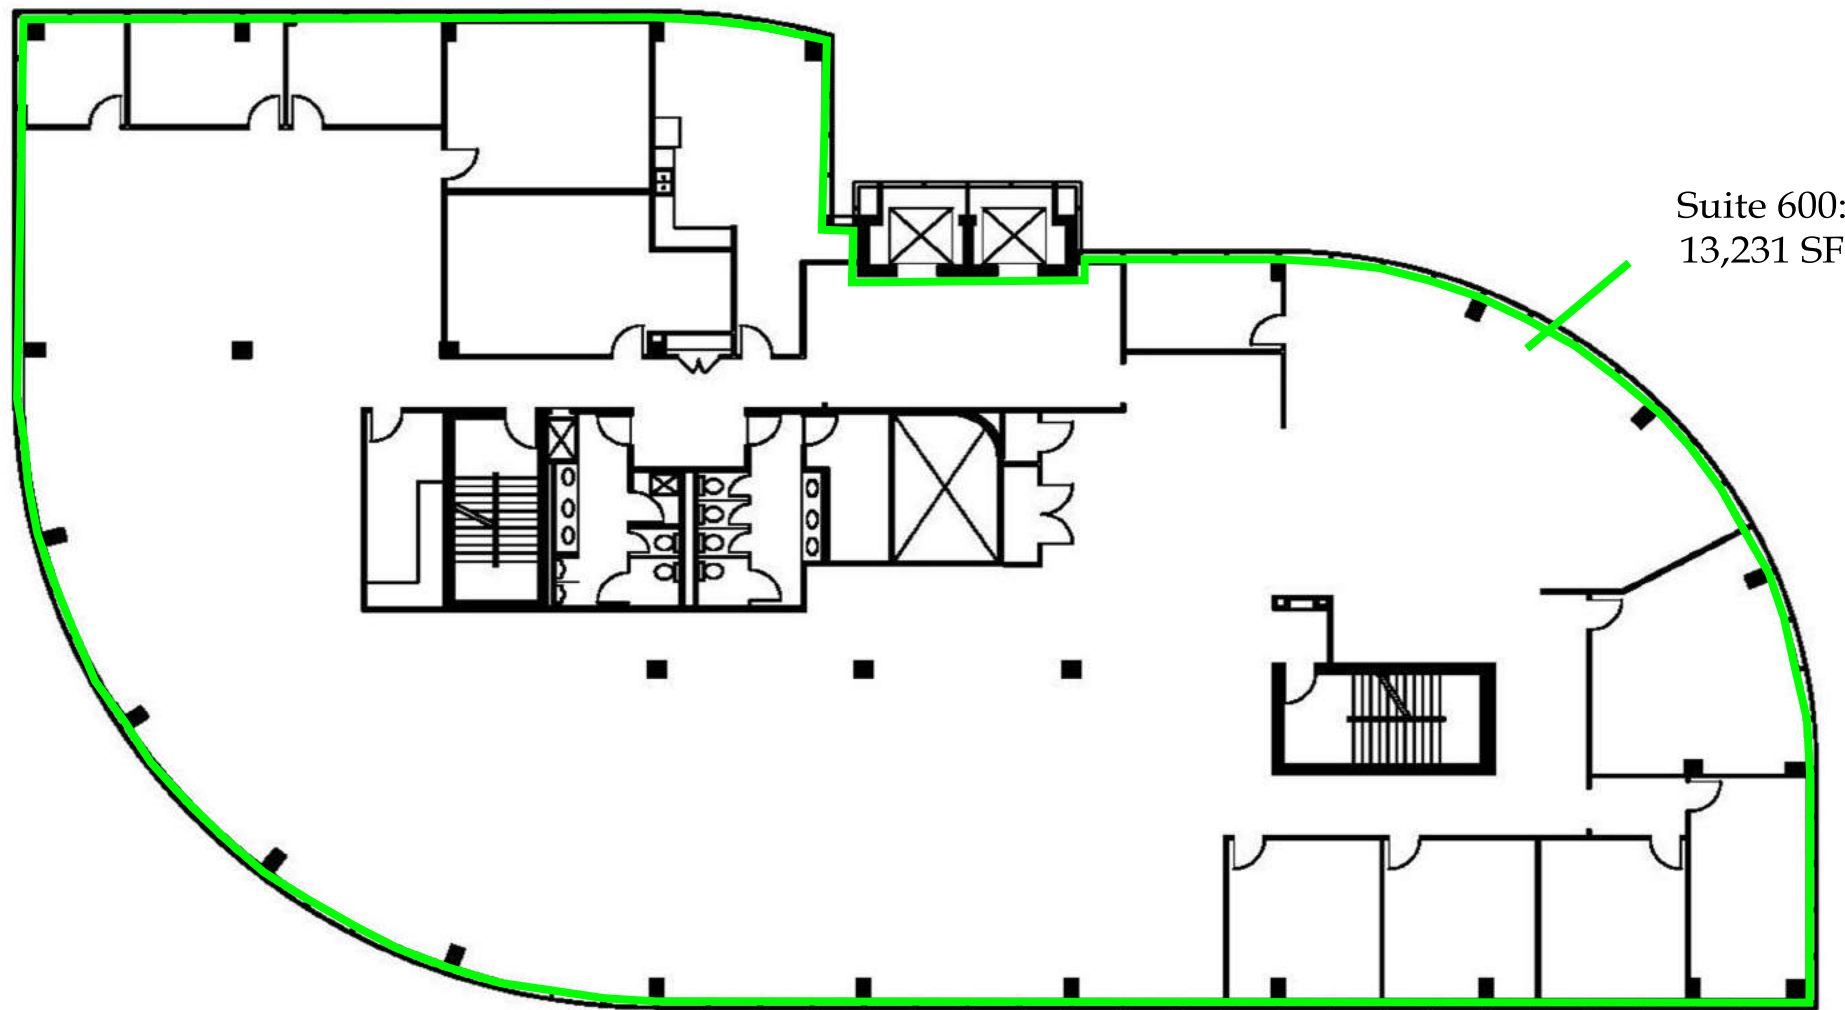

Suite 600:  
13,231 SF

SIXTH FLOOR AS-BUILT PLAN

Contact:

Clay Angelucci

O: 859.309.0099 x223

C: 859.338.8800

Clay@BALrealstate.com

Peter Barr CCIM, SIOR

O: 859.309.0099 x221

C: 859.351.7924


Peter@BALrealstate.com



BLOCK+LOT

# 230 Lexington Green Circle

## First Floor - Floor Plan

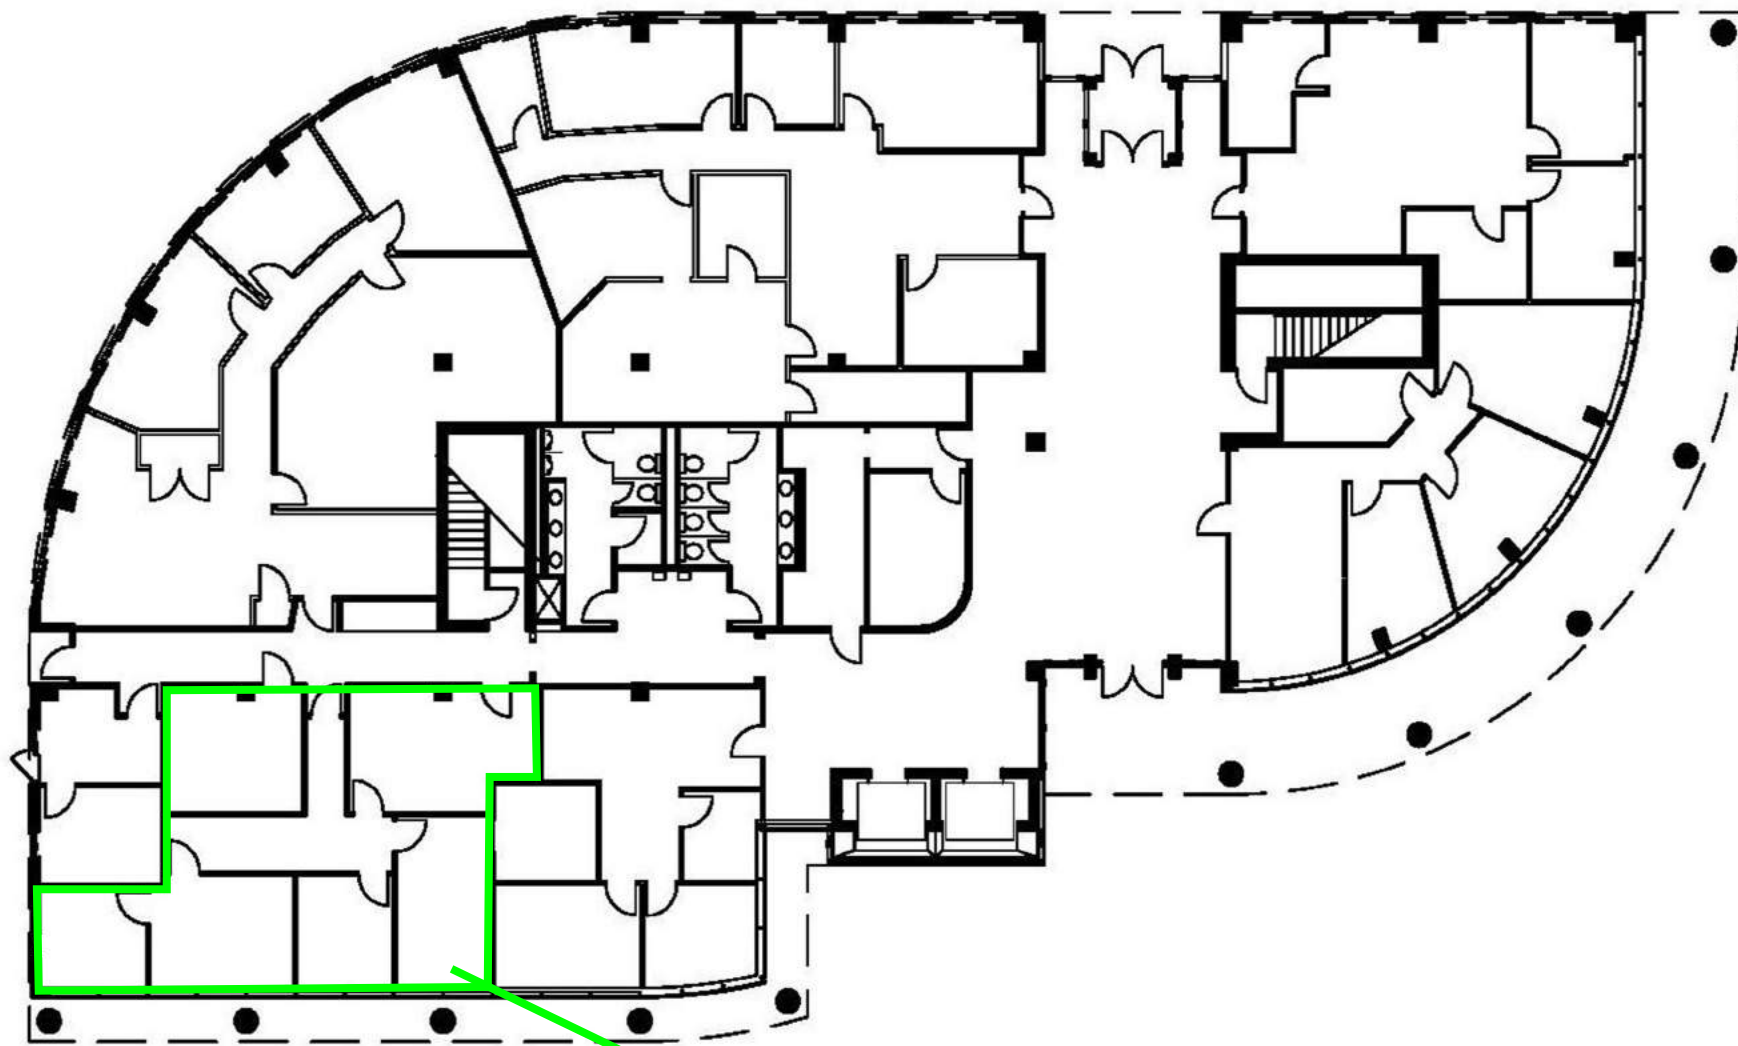

FIRST FLOOR AS-BUILT PLAN

Suites 116-119:  
163-1,209 SF

Contact:  
Clay Angelucci  
O: 859.309.0099 x223  
C: 859.338.8800  
Clay@BALrealstate.com


Peter Barr CCIM, SIOR  
O: 859.309.0099 x221  
C: 859.351.7924  
Peter@BALrealstate.com



# 230 Lexington Green Circle

## Second Floor - Floor Plan

Suite 230:  
1,428 SF

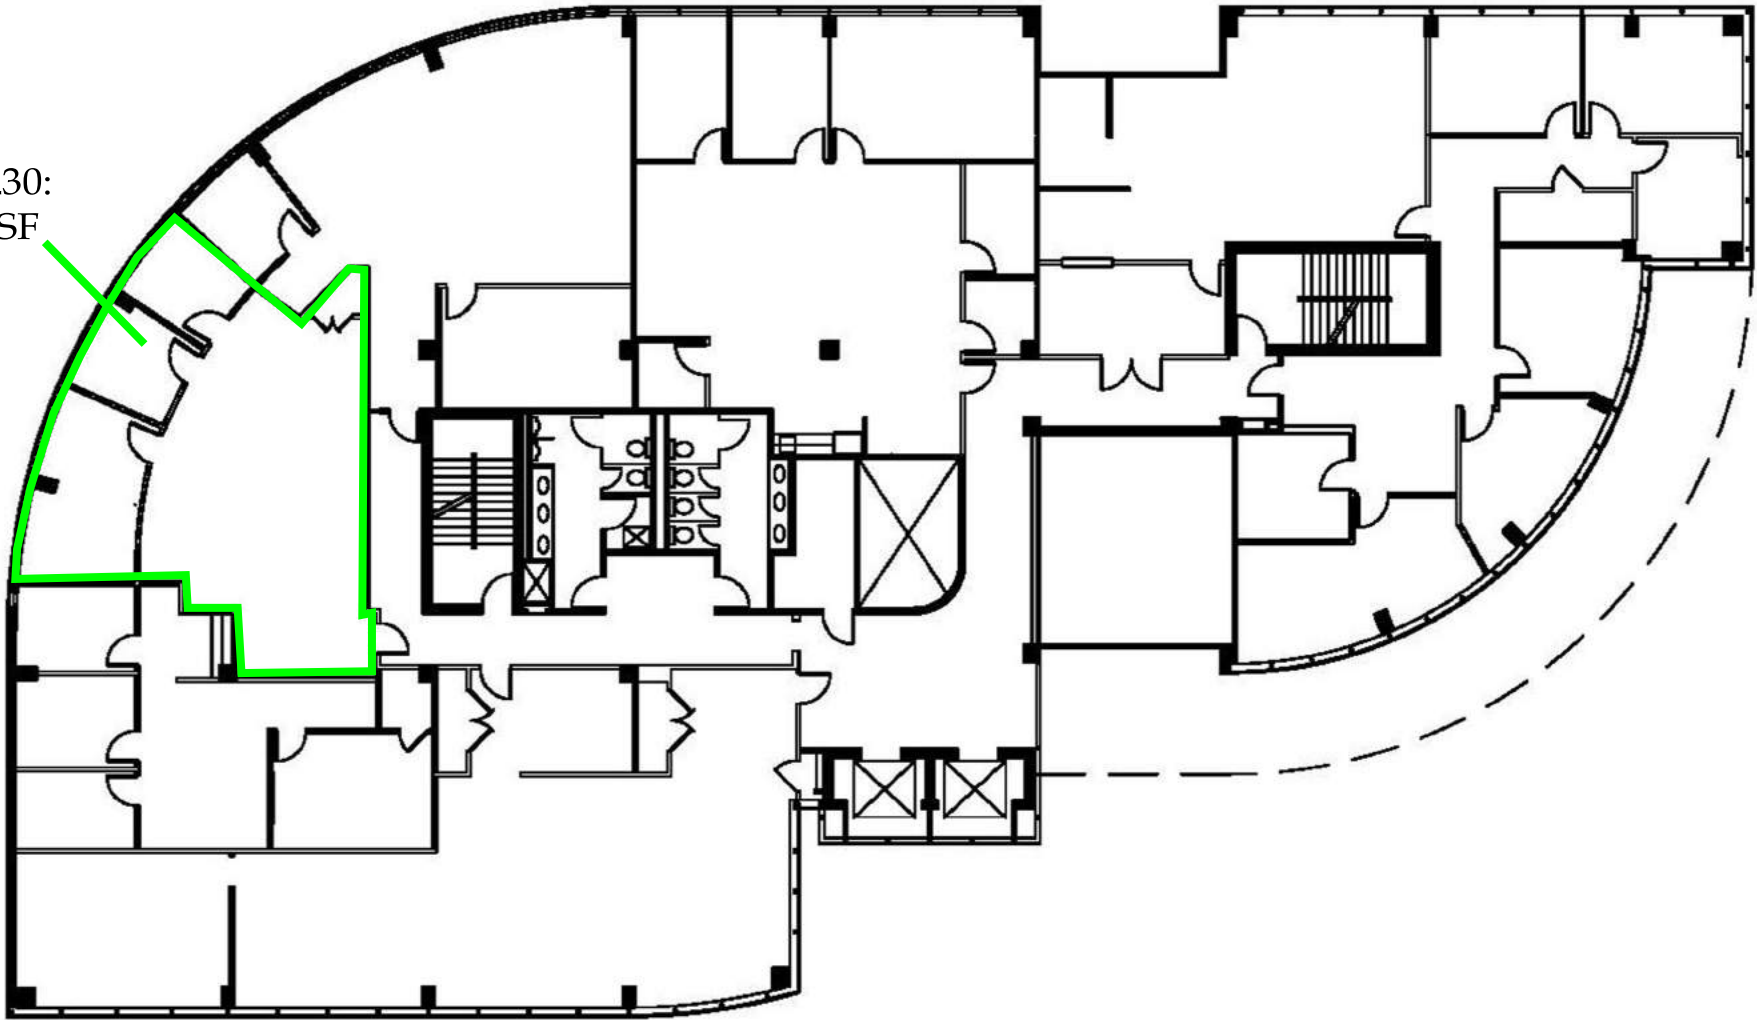

SECOND FLOOR AS-BUILT PLAN

Contact:

Clay Angelucci  
O: 859.309.0099 x223  
C: 859.338.8800  
Clay@BALrealstate.com


Peter Barr CCIM, SIOR  
O: 859.309.0099 x221  
C: 859.351.7924  
Peter@BALrealstate.com



BLOCK+LOT

# 230 Lexington Green Circle

## Fourth Floor - Floor Plan

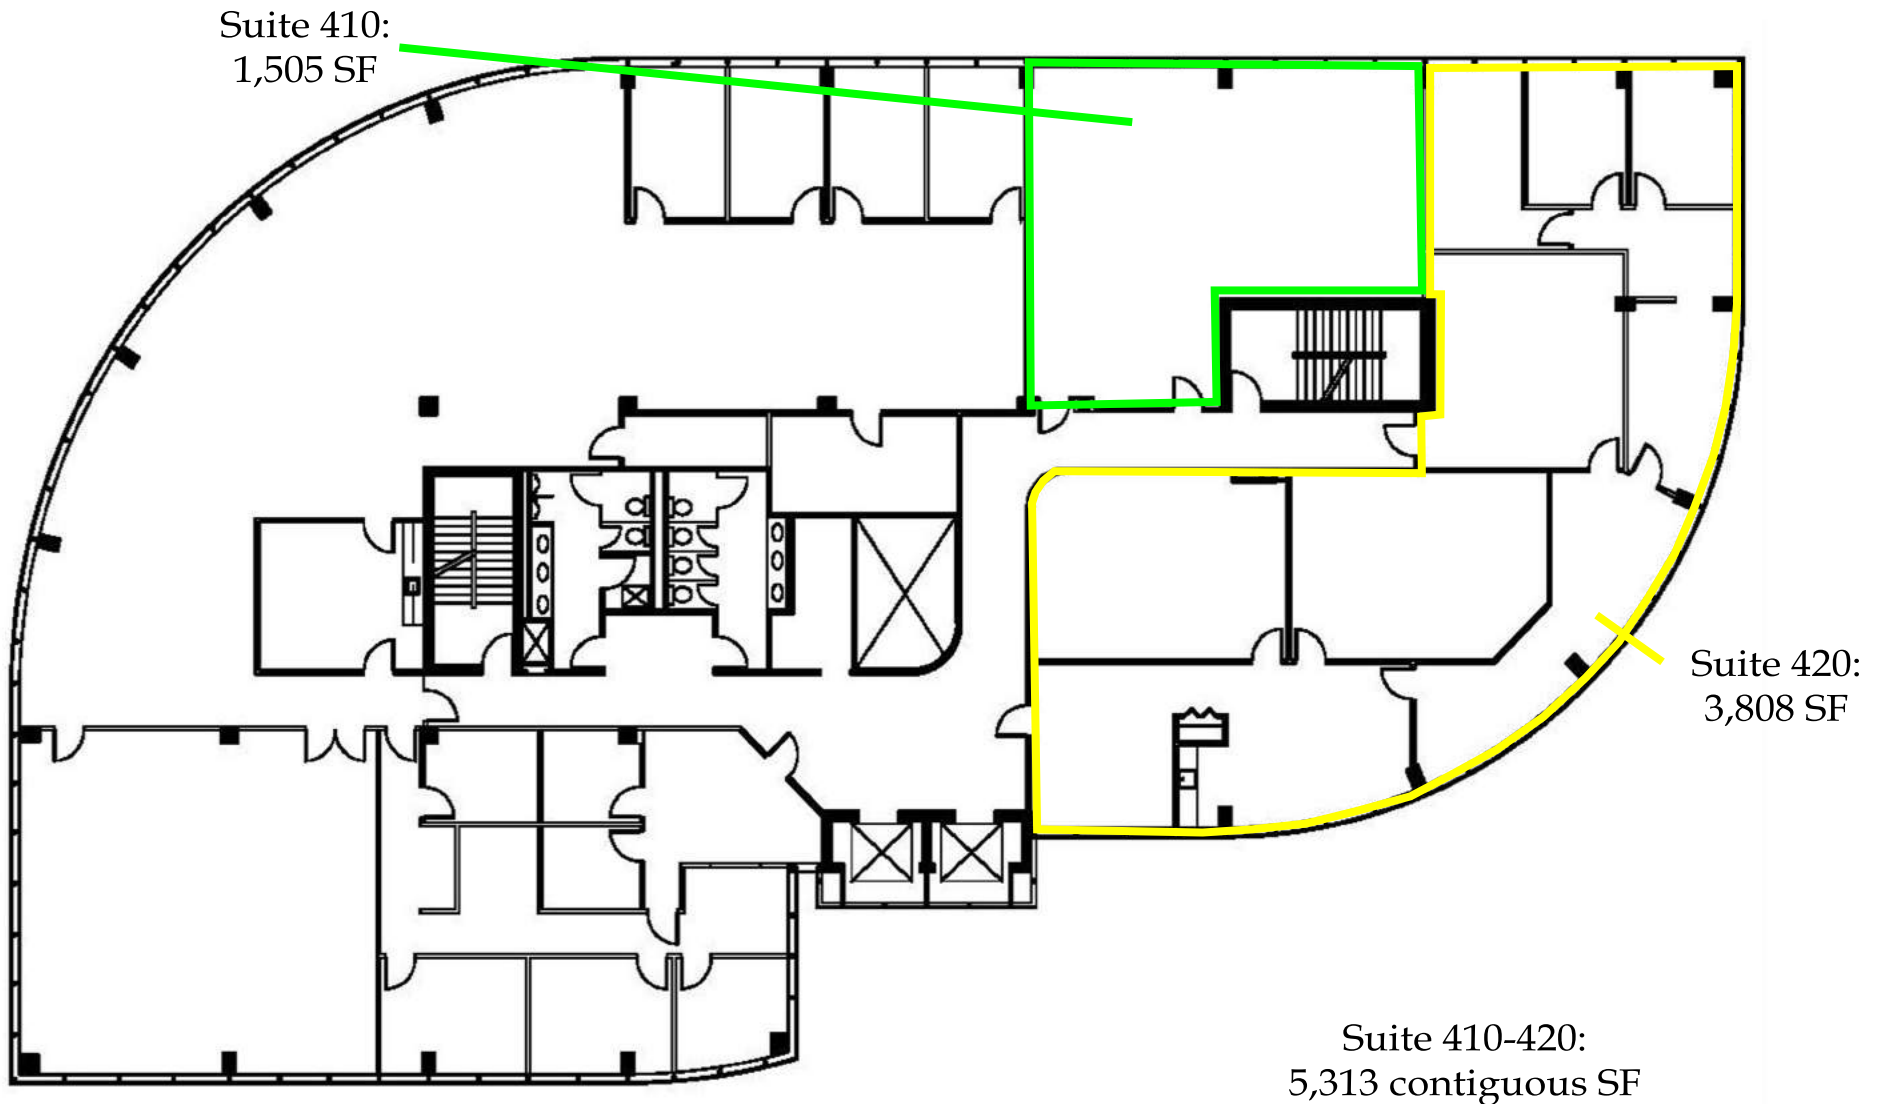

FOURTH FLOOR AS-BUILT PLAN

Contact:  
Clay Angelucci  
O: 859.309.0099 x223  
C: 859.338.8800  
Clay@BALrealstate.com

Peter Barr CCIM, SIOR  
O: 859.309.0099 x221  
C: 859.351.7924  
Peter@BALrealstate.com