


220 Lexington Green Circle

Second Floor - Floor Plan

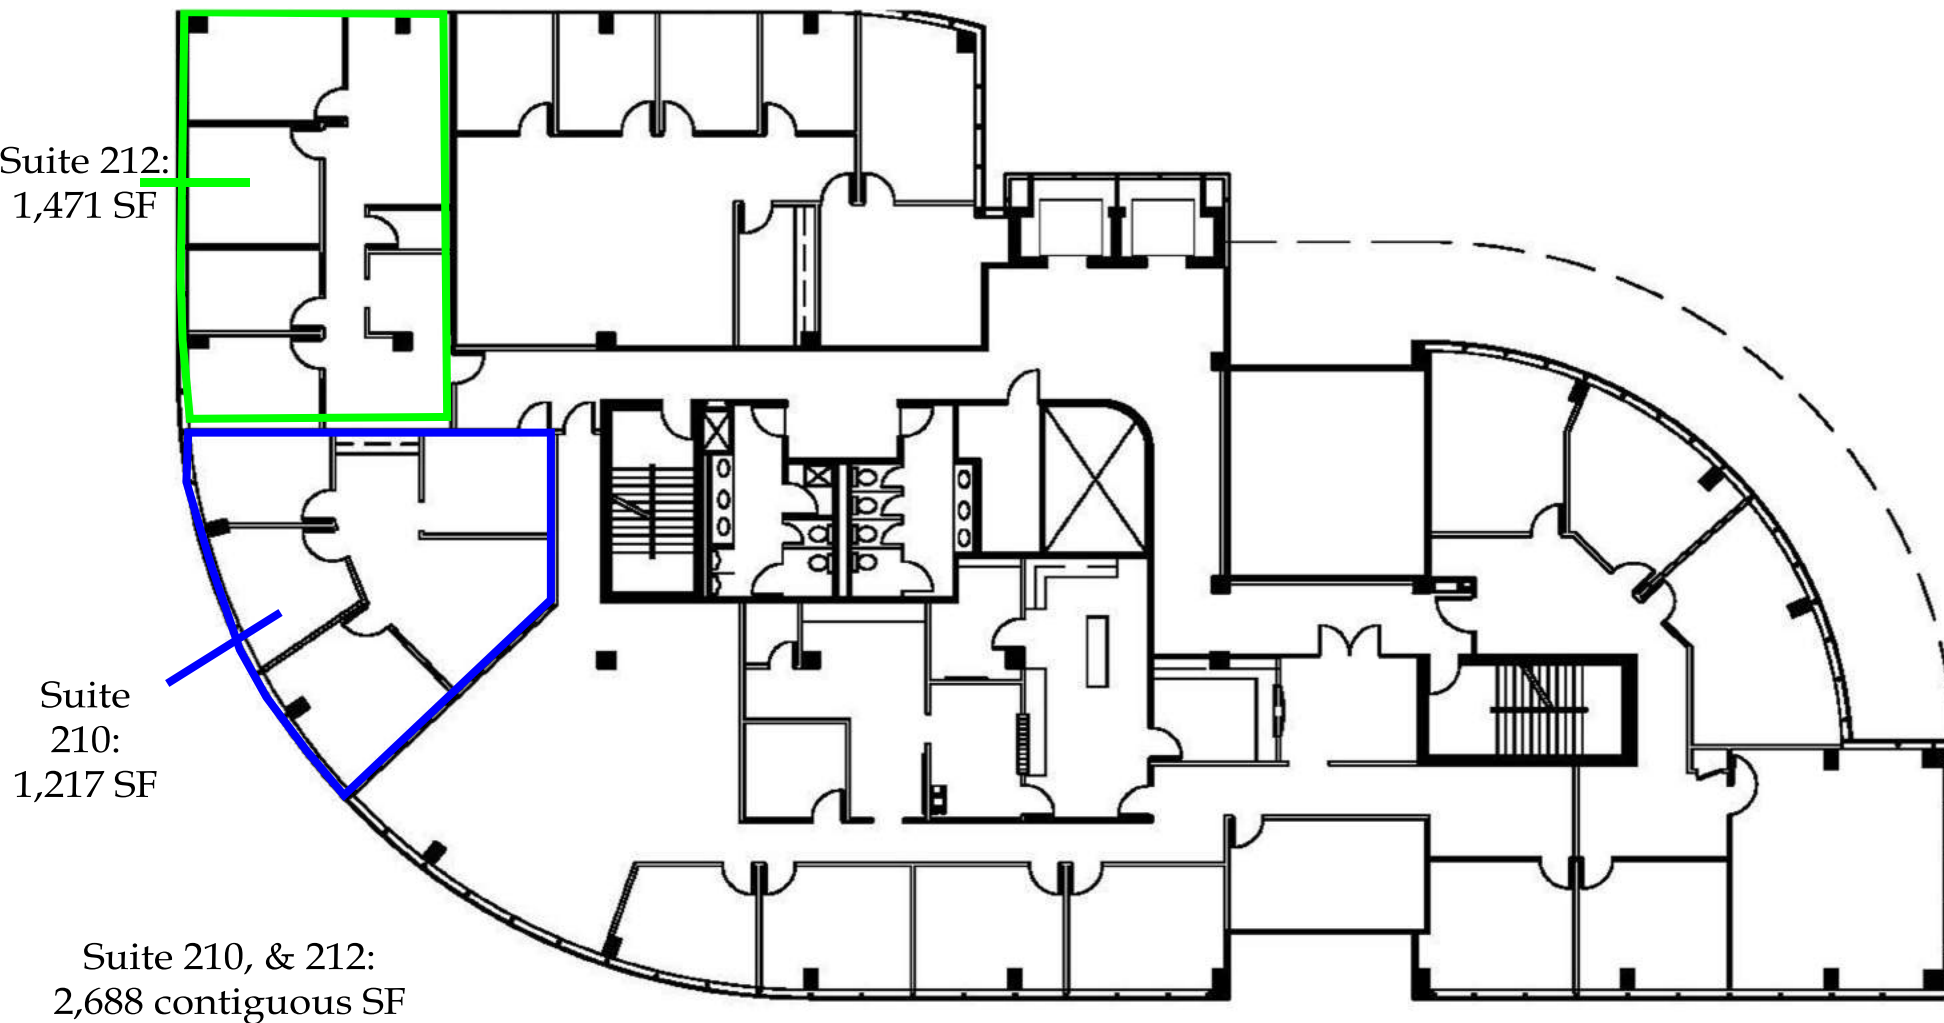


SECOND FLOOR AS-BUILT PLAN

Contact:
Clay Angelucci
O: 859.309.0099 x223
C: 859.338.8800
Clay@BALrealstate.com

Peter Barr CCIM, SIOR
O: 859.309.0099 x221
C: 859.351.7924
Peter@BALrealstate.com

220 Lexington Green Circle

Fourth Floor - Floor Plan

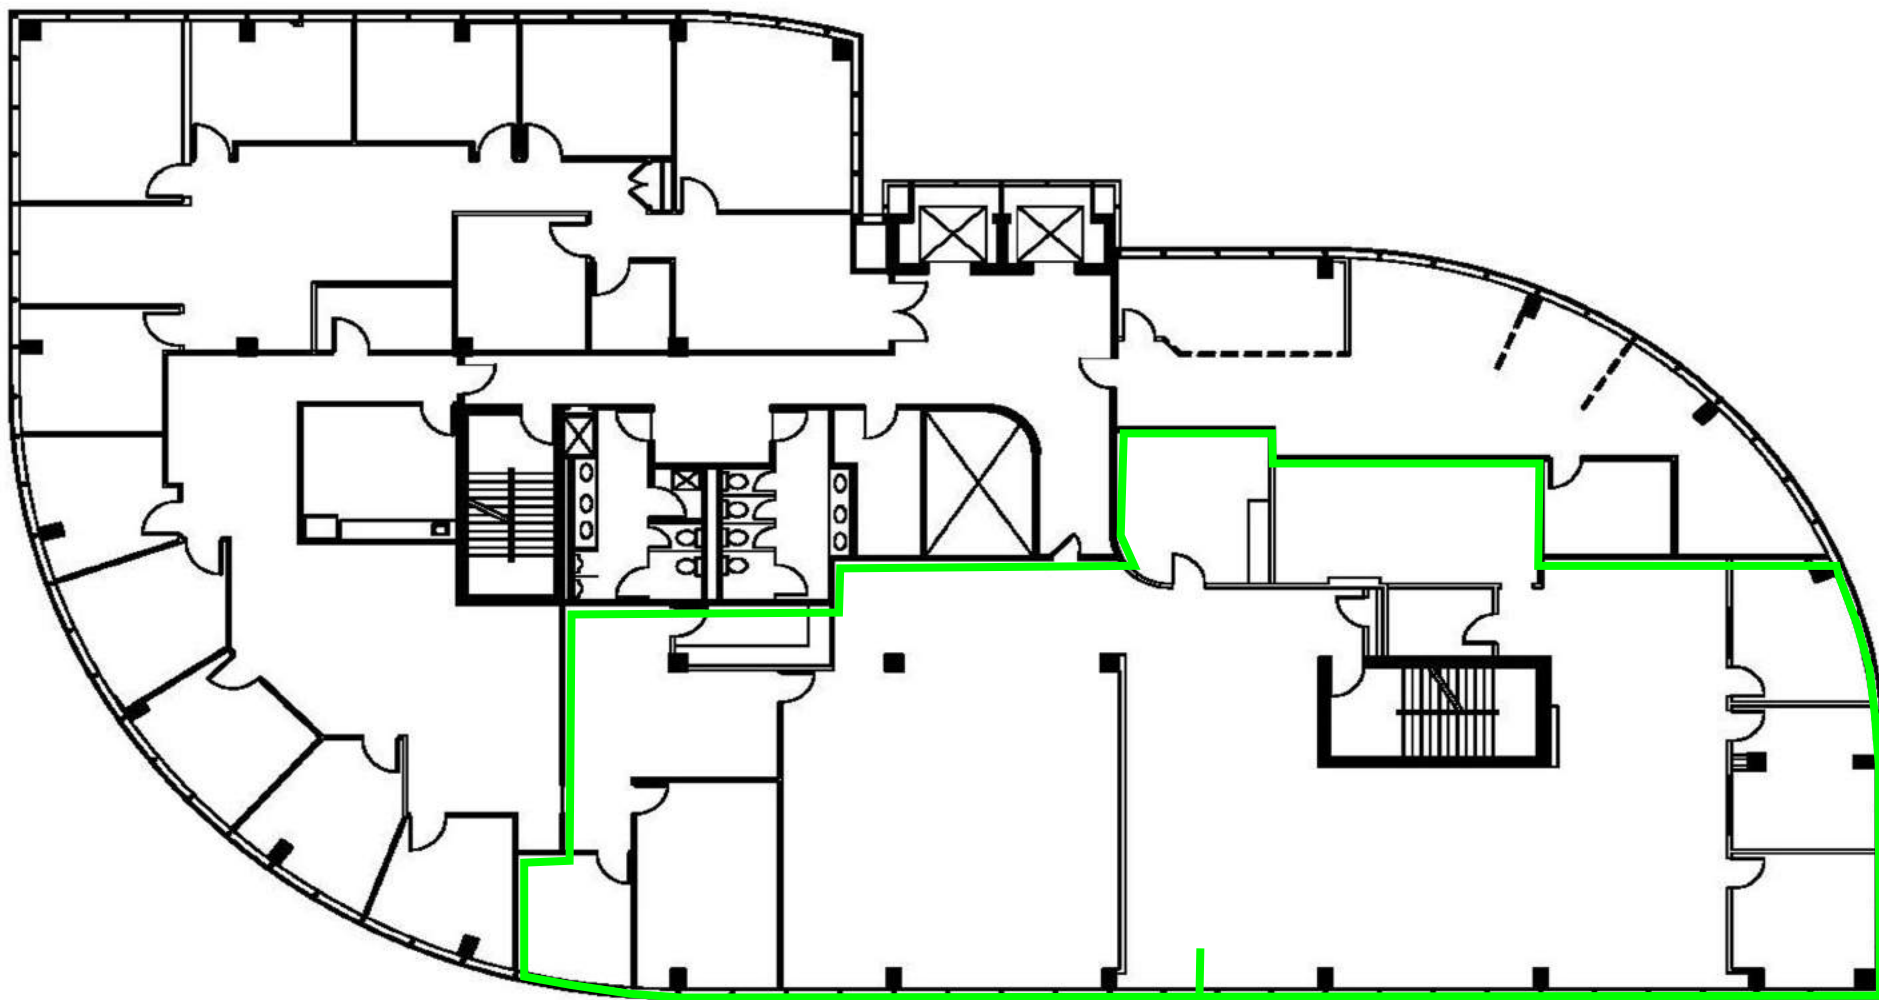

FOURTH FLOOR AS-BUILT PLAN


Suite 400:
6,586 SF

Contact:
Clay Angelucci
O: 859.309.0099 x223
C: 859.338.8800
Clay@BALrealstate.com

Peter Barr CCIM, SIOR
O: 859.309.0099 x221
C: 859.351.7924
Peter@BALrealstate.com

220 Lexington Green Circle

Fifth Floor - Floor Plan

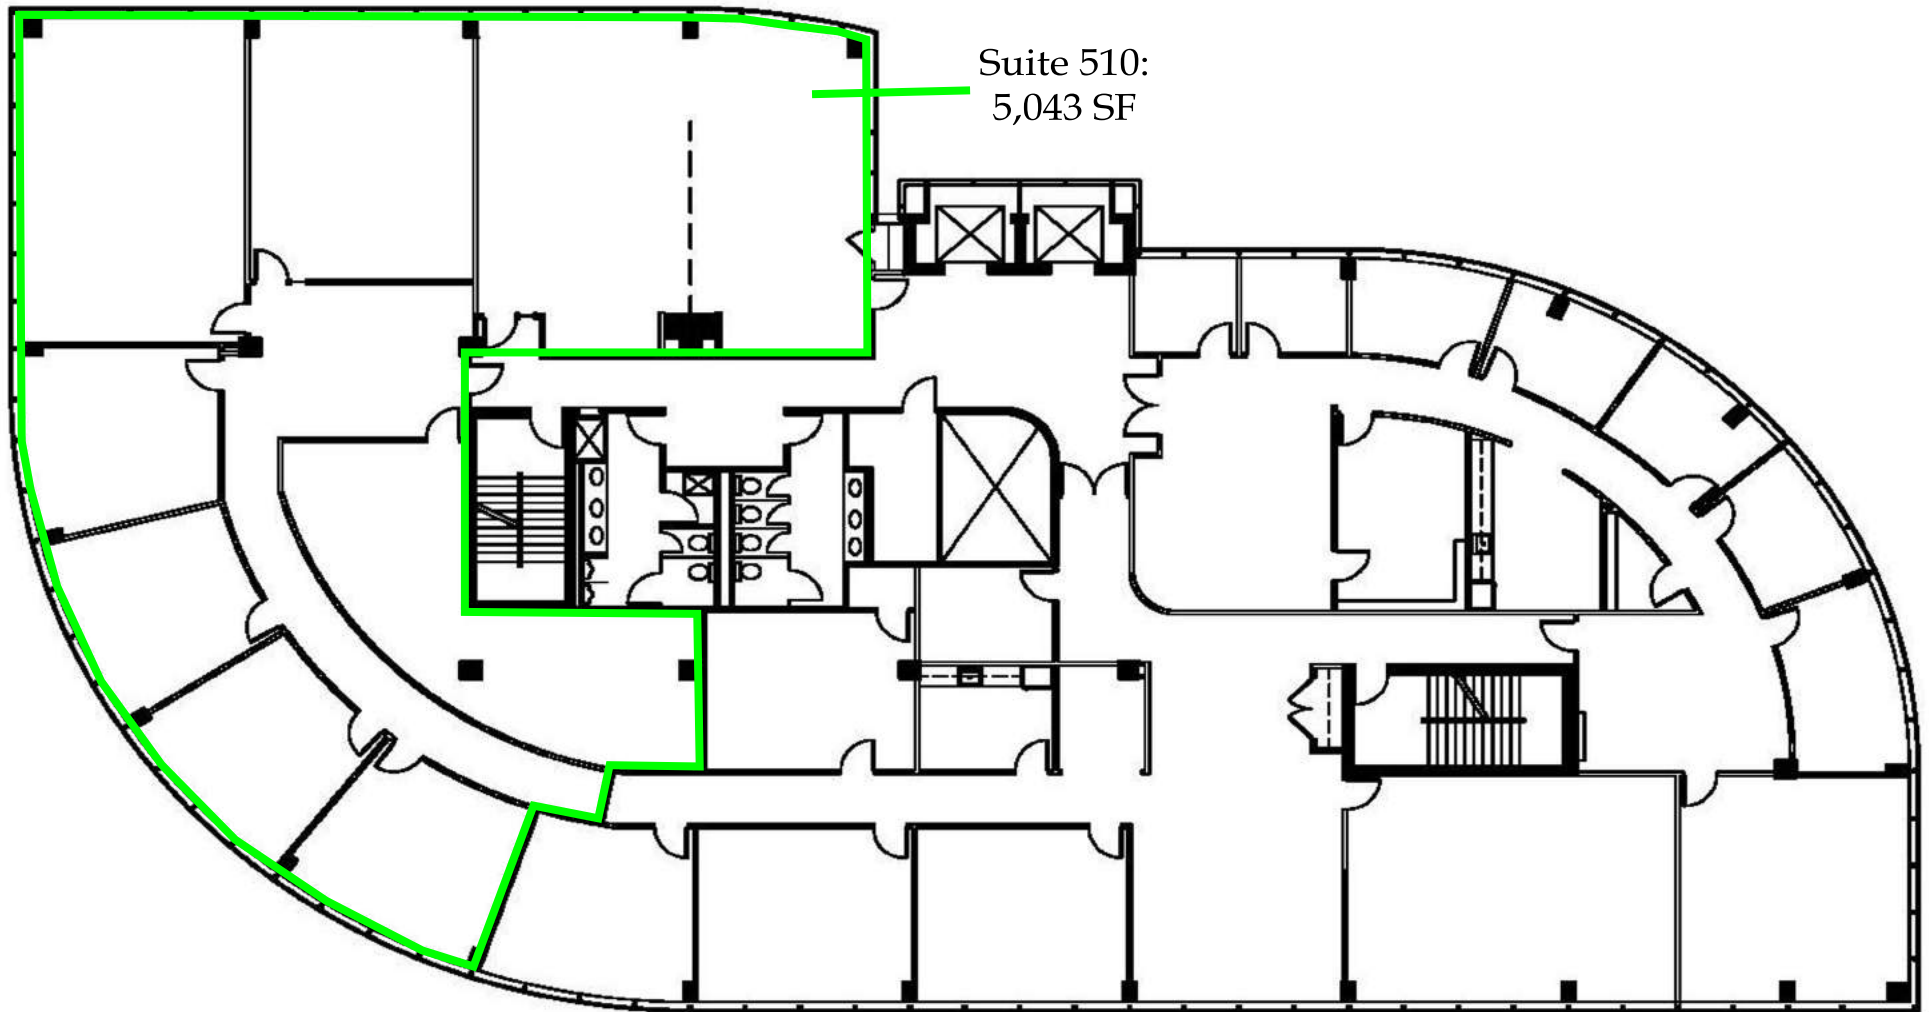

FIFTH FLOOR AS-BUILT PLAN

Contact:

Clay Angelucci

O: 859.309.0099 x223

C: 859.338.8800

Clay@BALrealstate.com

Peter Barr CCIM, SIOR

O: 859.309.0099 x221

C: 859.351.7924


Peter@BALrealstate.com



BLOCK+LOT

220 Lexington Green Circle

Sixth Floor - Floor Plan

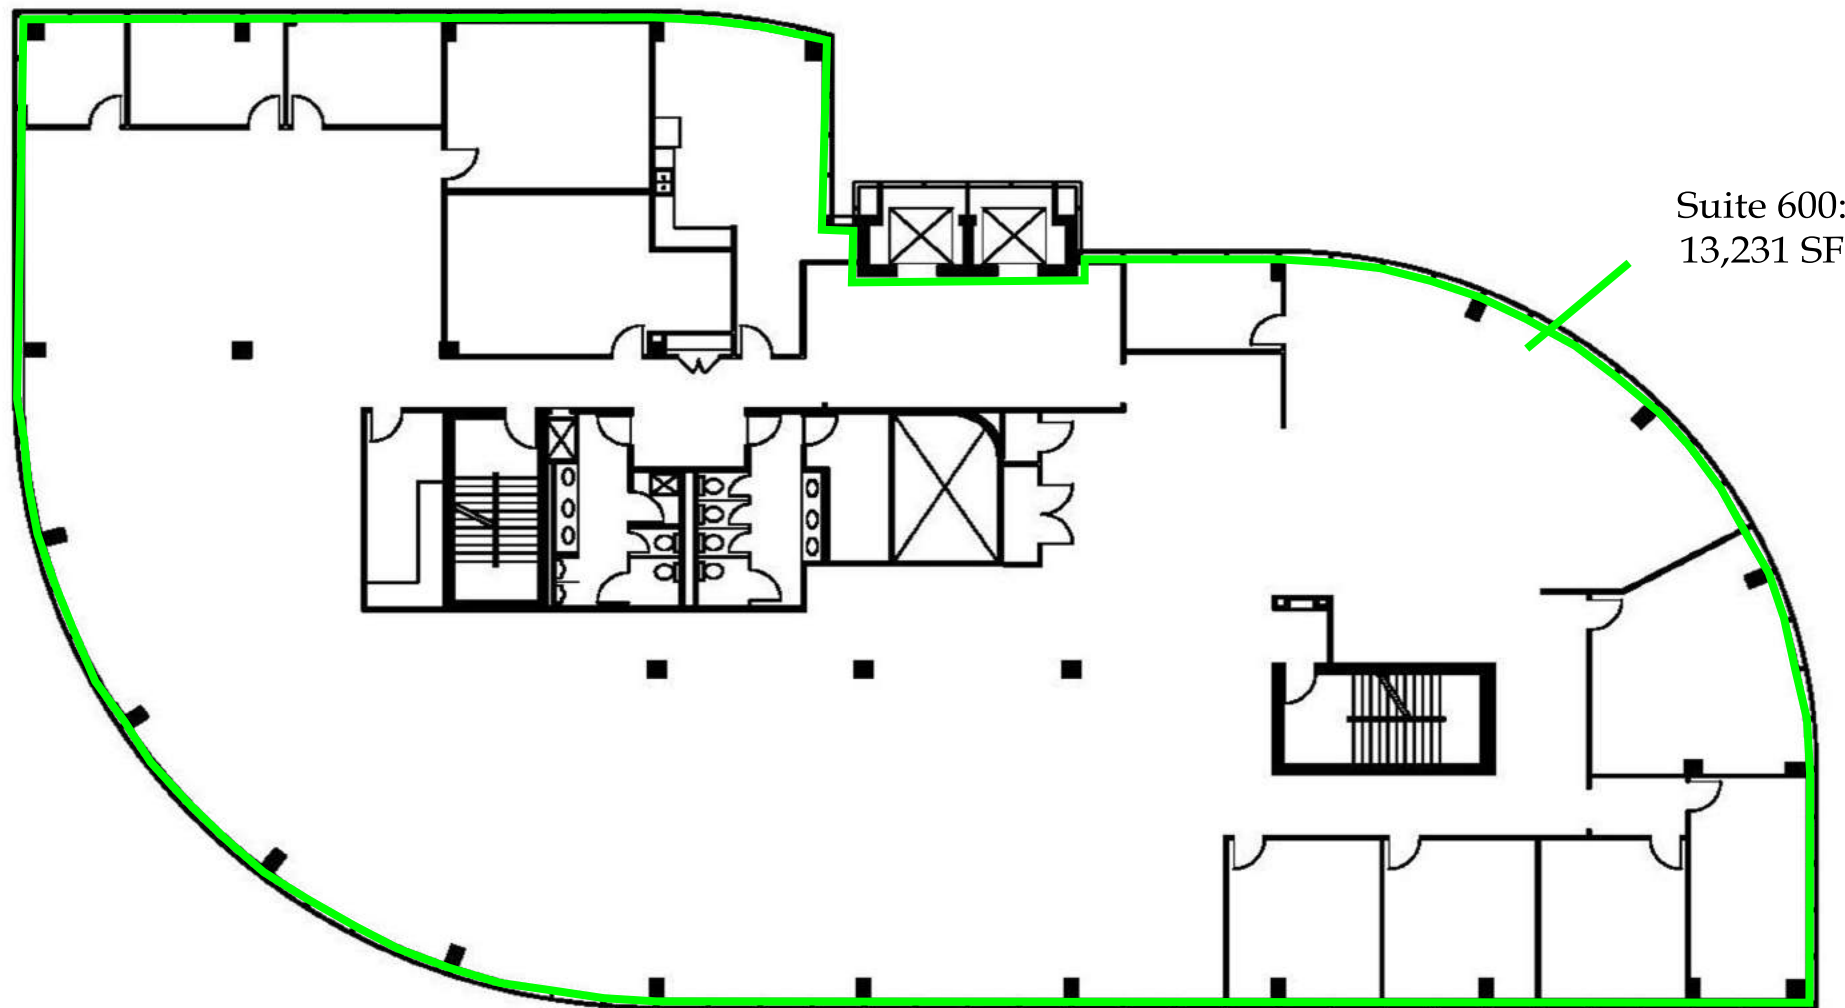

Suite 600:
13,231 SF

SIXTH FLOOR AS-BUILT PLAN

Contact:

Clay Angelucci

O: 859.309.0099 x223

C: 859.338.8800

Clay@BALrealstate.com

Peter Barr CCIM, SIOR

O: 859.309.0099 x221

C: 859.351.7924

Peter@BALrealstate.com




BLOCK+LOT

230 Lexington Green Circle

Second Floor - Floor Plan

Suite 230:
1,428 SF

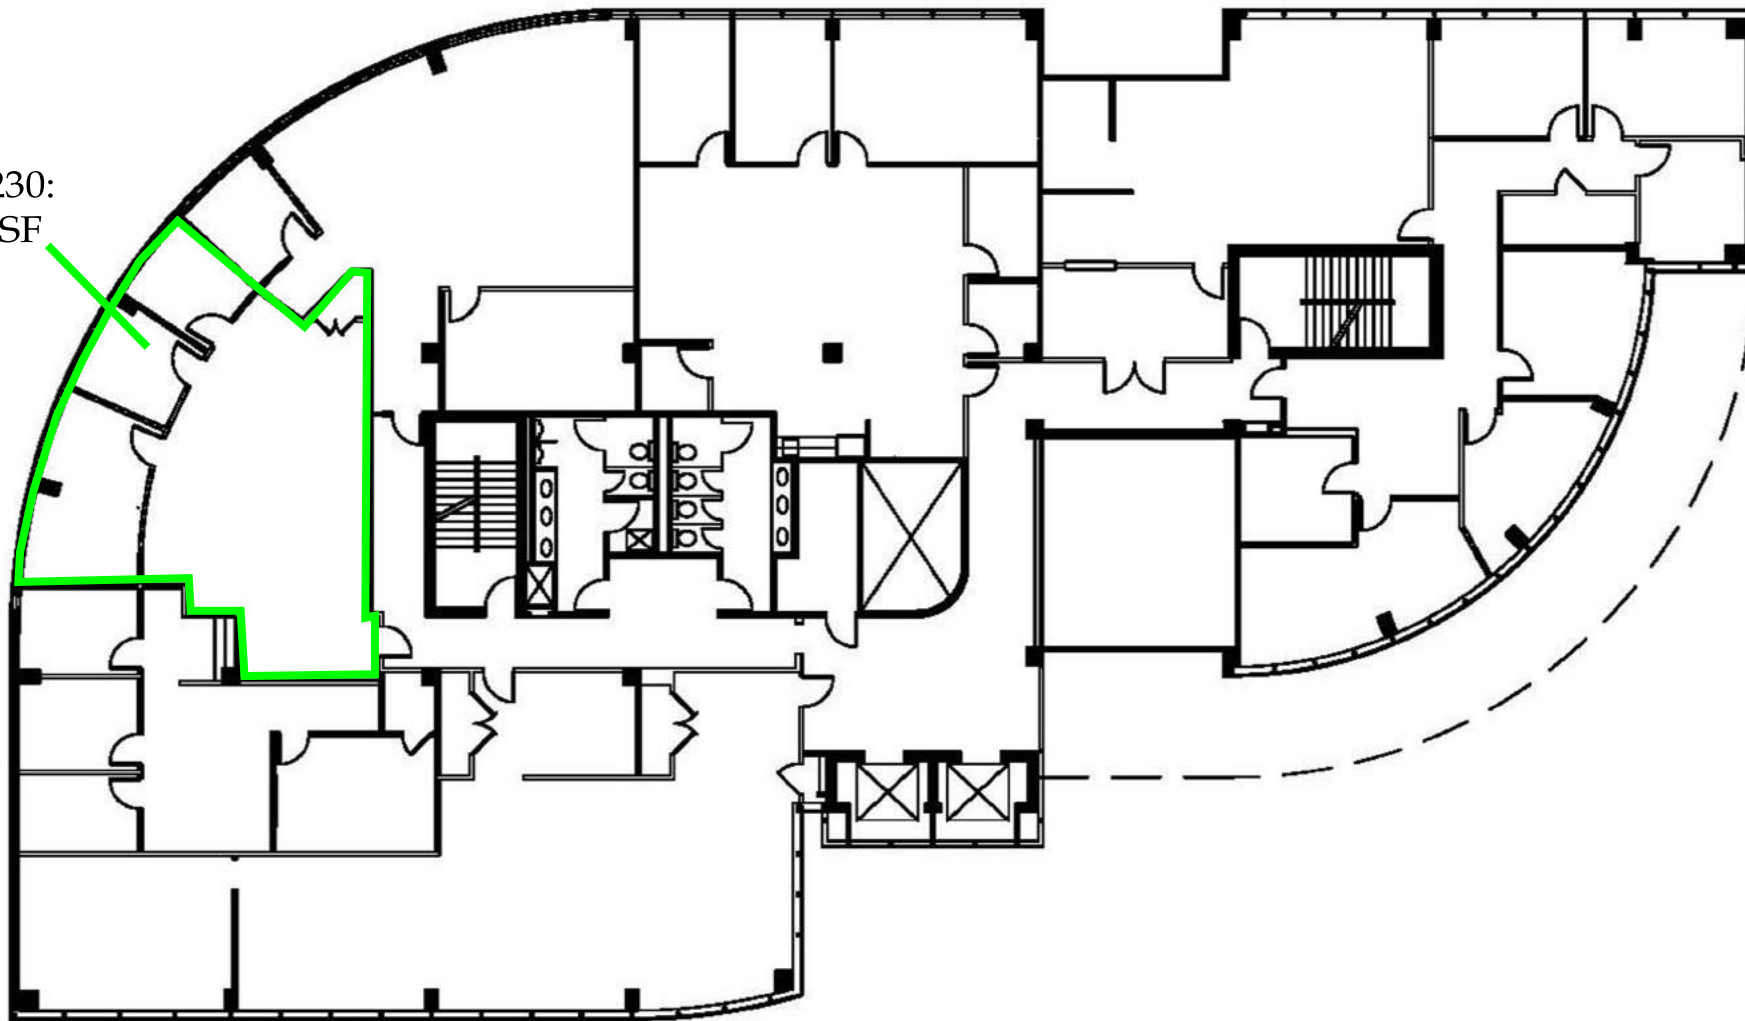

SECOND FLOOR AS-BUILT PLAN

Contact:

Clay Angelucci

O: 859.309.0099 x223

C: 859.338.8800

Clay@BALrealstate.com

Peter Barr CCIM, SIOR

O: 859.309.0099 x221

C: 859.351.7924


Peter@BALrealstate.com



BLOCK+LOT

230 Lexington Green Circle

Fourth Floor - Floor Plan

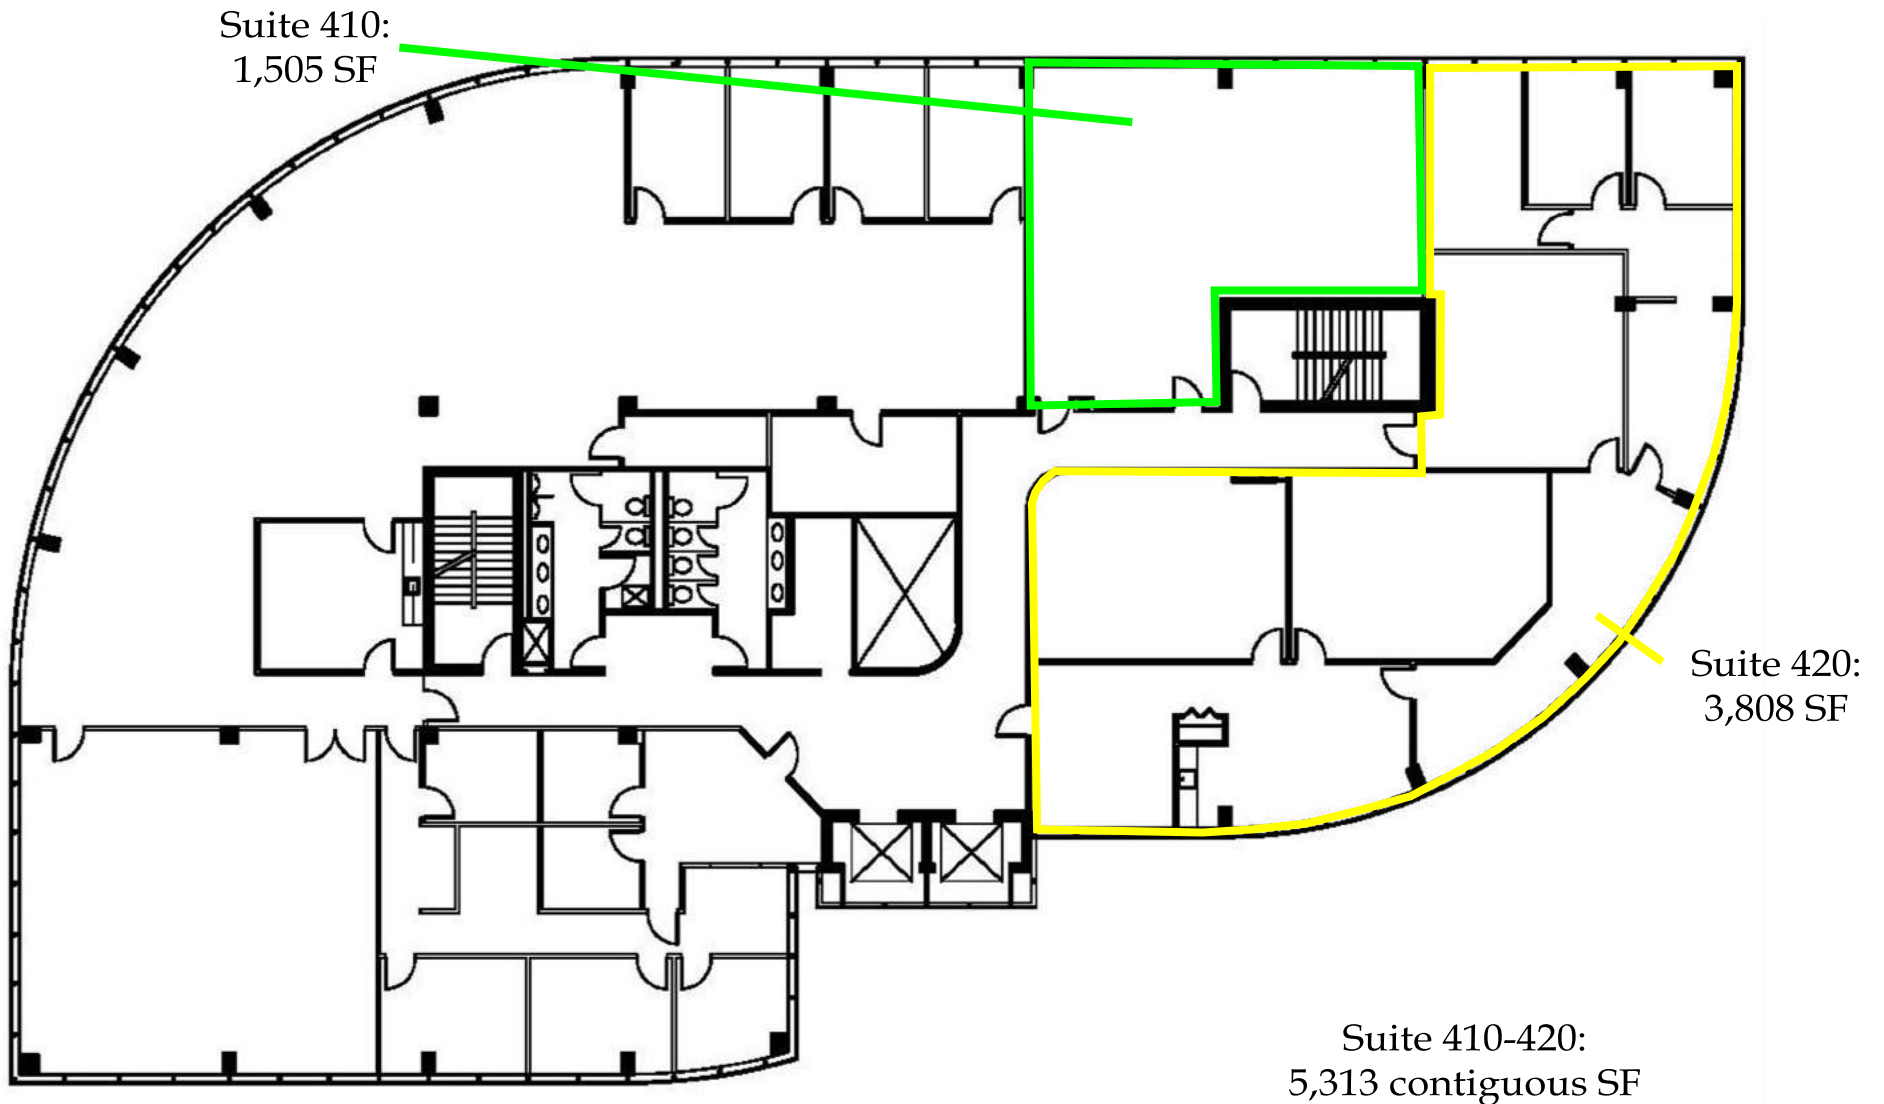

FOURTH FLOOR AS-BUILT PLAN